

Town of Tusayan PROPOSAL FORM

FY12/13 Snow Removal Services

A. Guidelines for contractors submitting quotes for sidewalk, parking lot, and employee housing driveway snow removal for the Town of Tusayan:

1. Sites must be plowed prior to 10 a.m., seven days a week.
2. Sites where piled snow is to be removed must have the snow removed within three calendar days following a snow event, as directed by the Town Manager.
3. Contractor will be responsible for monitoring snowfall and effect snow removal when accumulation at any location reaches 3-4".
4. Contractor must be available for plowing on a 24-hour, seven days per week basis.
5. Contractor shall make every effort to avoid damage to concrete and asphalt surfaces, and/or structures, landscaping, and decomposed granite. Damage caused by Contractor may be repaired by the Town and costs deducted from Contractor's billing.
6. Attached site plan may be used for illustrative purposes only. Dimensions given on plan should be considered estimated and contractor is responsible for confirming all measurements in the field.
7. All price quotes shall be submitted in in two formats, both as a "per event" fee and as an hourly "time and materials" fee to give the Town greatest flexibility in reviewing proposals to make its selection. Hourly "time and materials" fee proposed shall include the cost of equipment used, travel, labor, materials and applicable taxes.
8. The Town reserves the right to inspect all work and reject any or all substandard workmanship. Payments will be withheld until such time as substandard work is corrected.
9. All quotes must be completed and postmarked or received in person by 3 p.m. on Wednesday, December 19, 2012. Faxes and emails will not be accepted.

B. LOCATIONS & TYPE OF SERVICE

<u>Site # & location</u>	<u>Remove Piles</u>
1. Sidewalks along Highway 64 through Town	Yes
2. Town Hall parking lot and access drives, 845 Mustang Drive	Yes
3. Town of Tusayan Employee Housing Project driveways and entries (ADOT will plow road)	Yes

C. PROPOSAL

Company Name: _____ License #: _____

Address: _____

Phone Number: _____ Cell Number: _____

Email Address: _____

Per event fee proposed: _____

Hourly "time and materials" fee proposed:

Labor rate	\$ _____/hour
Bobcat	\$ _____/hour
Snow Blower	\$ _____/hour
Pickup w/ Plow	\$ _____/hour
Backhoe	\$ _____/hour
Front-end Loader	\$ _____/hour
Dump Truck	\$ _____/hour
Hand Labor	\$ _____/hour
Other _____	\$ _____/hour

Additional information relevant to proposal:

D. REFERENCES

Name: _____ Phone No.: _____

Name: _____ Phone No.: _____

Name: _____ Phone No.: _____


E. RESPONSIBLE PARTY

Print Name: _____

Authorized Signature: _____

Title: _____ Date: _____

STATE	PROJECT NO.	SHEET NO.	TOTAL SHEETS	AS BUILT
9	064-AI202	3	142	
064 CN 235				

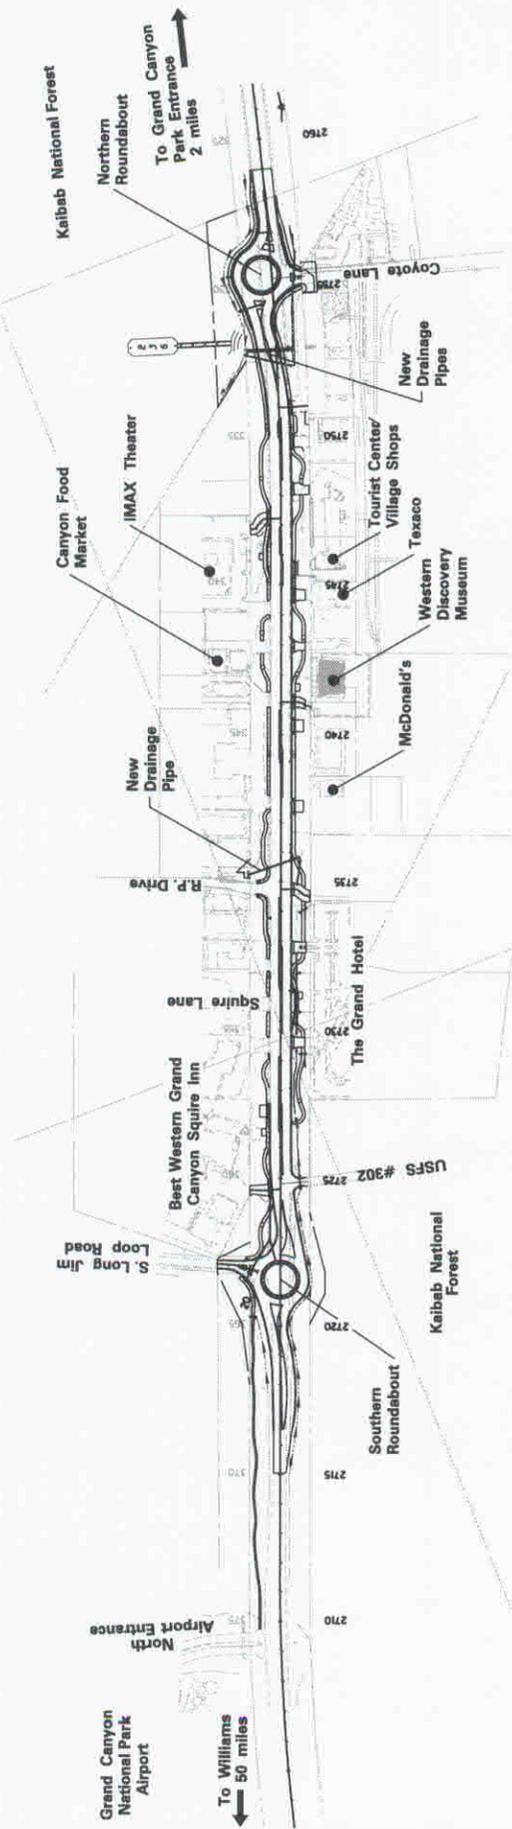

		ARIZONA DEPARTMENT OF TRANSPORTATION INTERMODAL TRANSPORTATION DIVISION	
DATE: 04-11 DESIGNED BY: SP DRAWN BY: SP	DATE: 04-11 CHECKED BY: SP DATE: 04-11	PROJECT KEYMAP SR 64, MP 235 TUSAYAN STREET IMPROVEMENTS	
TITLE: SR 64 LOCATION: TUSAYAN STREET IMPROVEMENTS		TRACS NO.: H6927 01C 064-AI2021	
PROJECT NO.: H6927 01C		SHEET NO.: 3 OF 142	

H:\Microstation\client\FCA\001_V8\VIEW\user\ar\vee\0\512330.dgn
 5/23/08 AM